



Penn**FIRST**



Cloud Gehshan  
Design



Penn**Medicine**



New Patients Pavilion Donor/Dedication Signage  
The Hospital of the University of Pennsylvania  
1 Convention Avenue, Philadelphia, PA 19104



**JOB SPECIFICATIONS**

User Name: Penn First  
 Job Name: Penn First Pavilion Donor AS BUILT  
 Job #: 51856  
 Customer Name: Cloud Gehshan  
 Sales Rep: EJ | Drawn By: MLH  
 Revision #: 2  
 Sign Type: Room Dedication-Tier 1  
 Date: 08.02.2022  
 File Location: Penn First\AS BUILT

**SIGN PANEL**

Face: 1/8" Bronze  
 Edges: Straight  
 Corners: Square  
 COLOR | 1st Surf: Blacked Bronze  
 COLOR | 2nd Surf: NA  
 Insert/Slat: NA  
 Vinyl: NA  
 2nd Layer: NA  
 COLOR | 1st Surf: NA  
 COLOR | 2nd Surf: NA  
 Sides: Single

**CONTENT**



Process: UV direct print  
 TEXT/COPY | Height: See Drawing  
 TEXT/COPY | Style: Calibre Thin and Regular  
 TEXT/COPY | Color: White  
 Braille: NA

**MOUNTING**

Hardware: NA  
 Holes/Location: NA  
 Tape: DS Foam VHB  
 Mounting Surface: TBD  
 Glass Backer Mat/Color: NA

**FRAME**

Type: (Cap) PVC Moulded  
 Size: See Drawing  
 Color: MP PFcopper

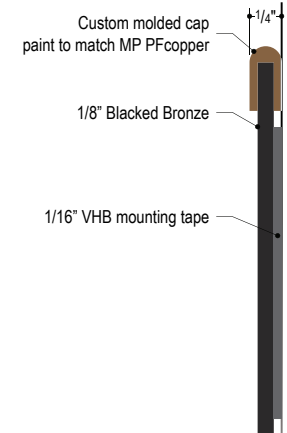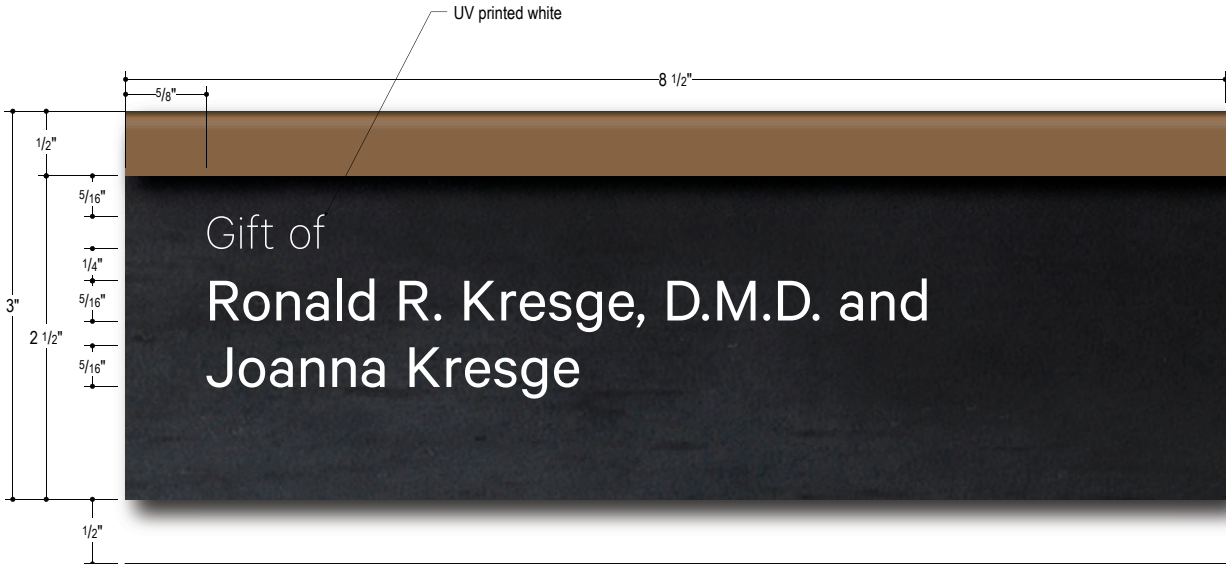

Approved by:

Date:



**JOB SPECIFICATIONS**

User Name:	Penn First	
Job Name:	Penn First Pavilion Donor AS BUILT	
Job #:	51856	
Customer Name:	Cloud Gehshan	
Sales Rep:	EJ	Drawn By: MLH
Revision #:	2	
Sign Type:	Room Dedication-Tier 2	
Date:	08.02.2022	
File Location:	Penn First\AS BUILT	

**SIGN PANEL**

Face:	1/8" Bronze	
Edges:	Straight	
Corners:	Square	
COLOR	1st Surf:	Blackened Bronze
COLOR	2nd Surf:	NA
Insert/Slat:	NA	
Vinyl:	NA	
2nd Layer:	NA	
COLOR	1st Surf:	NA
COLOR	2nd Surf:	NA
Sides:	Single	

**CONTENT**



Process:	UV direct print	
TEXT/COPY	Height:	See Drawing
	Style:	Calibre Thin and Regular
	Color:	White
Braille:	NA	

**MOUNTING**

Hardware:	NA	
Holes/Location:	NA	
Tape:	DS Foam VHB	
Mounting Surface:	TBD	
Glass Backer Mat/Color:	NA	



**FRAME**

Type:	(Cap) PVC Moulded	
Size:	See Drawing	
Color:	MP PFCopper	

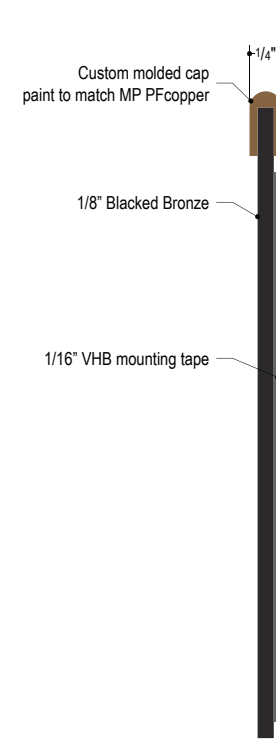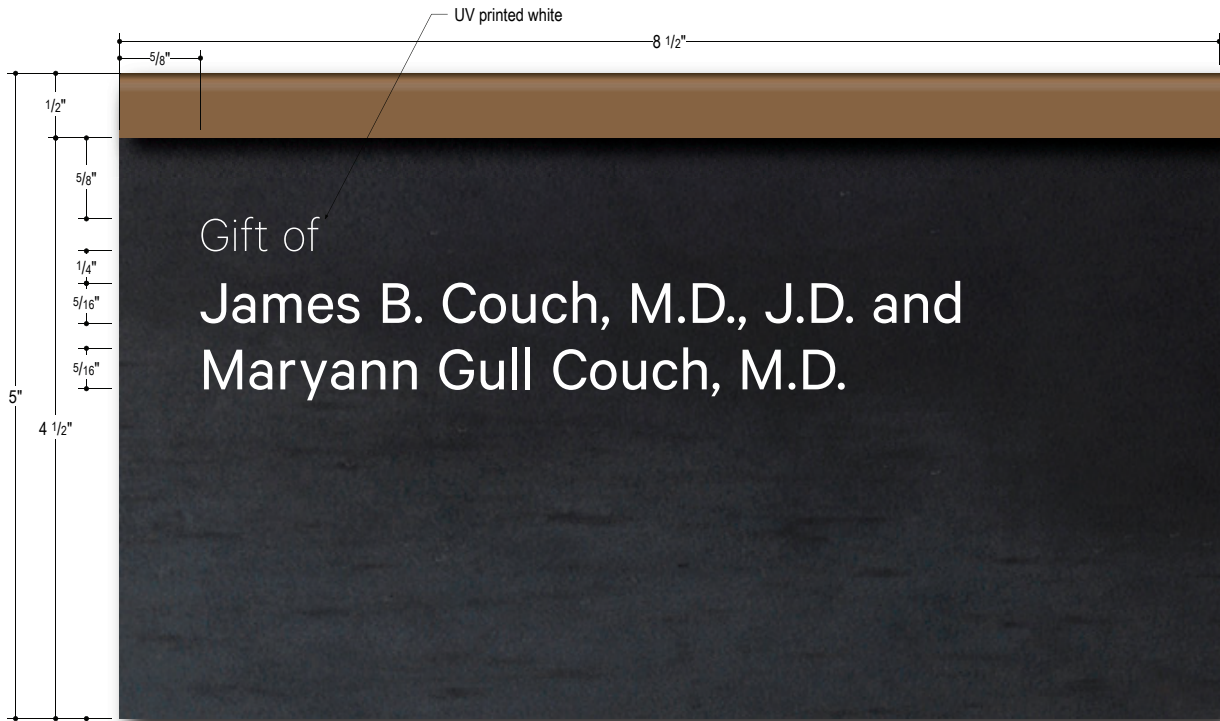

Approved by:

Date:

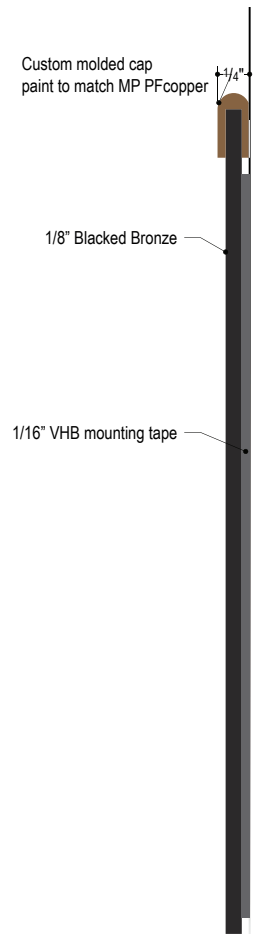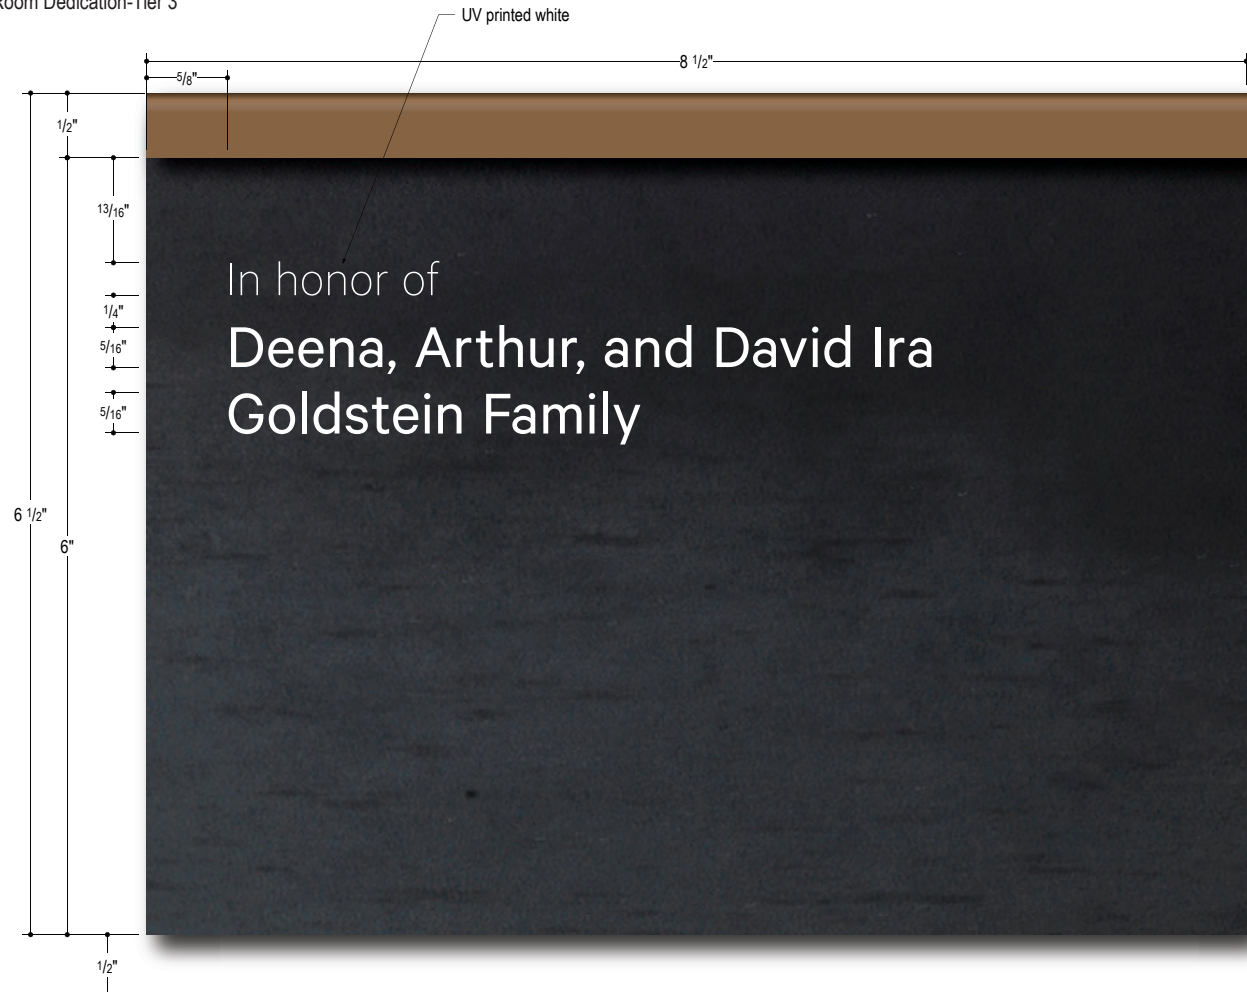

**JOB SPECIFICATIONS**

User Name: Penn First	
Job Name: Penn First Pavilion Donor AS BUILT	
Job #: 51856	
Customer Name: Cloud Gehshan	
Sales Rep: EJ	Drawn By: MLH
Revision #: 1	
Sign Type: Room Dedication-Tier 3	
Date: 08.02.2022	
File Location: Penn First\AS BUILT	

**SIGN PANEL**

Face: 1/8" Bronze	
Edges: Straight	
Corners: Square	
COLOR	1st Surf: Blacked Bronze
	2nd Surf: NA
Insert/Slat: NA	
Vinyl: NA	
2nd Layer: NA	
COLOR	1st Surf: NA
	2nd Surf: NA
Sides: Single	

**CONTENT**

Process: UV direct print	
TEXT/COPY	Height: See Drawing
	Style: Calibre Thin and Regular
	Color: White
Braille: NA	

**MOUNTING**

Hardware: NA	
Holes/Location: NA	
Tape: DS Foam VHB	
Mounting Surface: TBD	
Glass Backer Mat/Color: NA	

**FRAME**

Type: (Cap) PVC Moulded	
Size: See Drawing	
Color: MP PFcopper	

Approved by:

Date:



**JOB SPECIFICATIONS**

User Name: Penn First	
Job Name: Penn First Pavilion Donor AS BUILT	
Job #: 51856	
Customer Name: Cloud Gehshan	
Sales Rep: EJ	Drawn By: MLH
Revision #: 2	
Sign Type: Room Dedication-Tier 1, w/ text	
Date: 08.02.2022	
File Location: Penn First\AS BUILT	

**SIGN PANEL**

Face: 1/8" Bronze	
Edges: Straight	
Corners: Square	
COLOR	1st Surf: Blacked Bronze
	2nd Surf: NA
Insert/Slat: NA	
Vinyl: NA	
2nd Layer: NA	
COLOR	1st Surf: NA
	2nd Surf: NA
Sides: Single	

**CONTENT**


Process: Engraved (UV PRINTED WHITE TEXT)	
TEXT/COPY	Height: See Drawing
	Style: Calibre Thin and Regular
	Color: White, MP PFCopper
Braille: NA	

**MOUNTING**

Hardware: NA	
Holes/Location: NA	
Tape: DS Foam VHB	
Mounting Surface: TBD	
Glass Backer Mat/Color: NA	

**FRAME**

Type: (Cap) PVC Moulded	
Size: See Drawing	
Color: MP PFCopper	

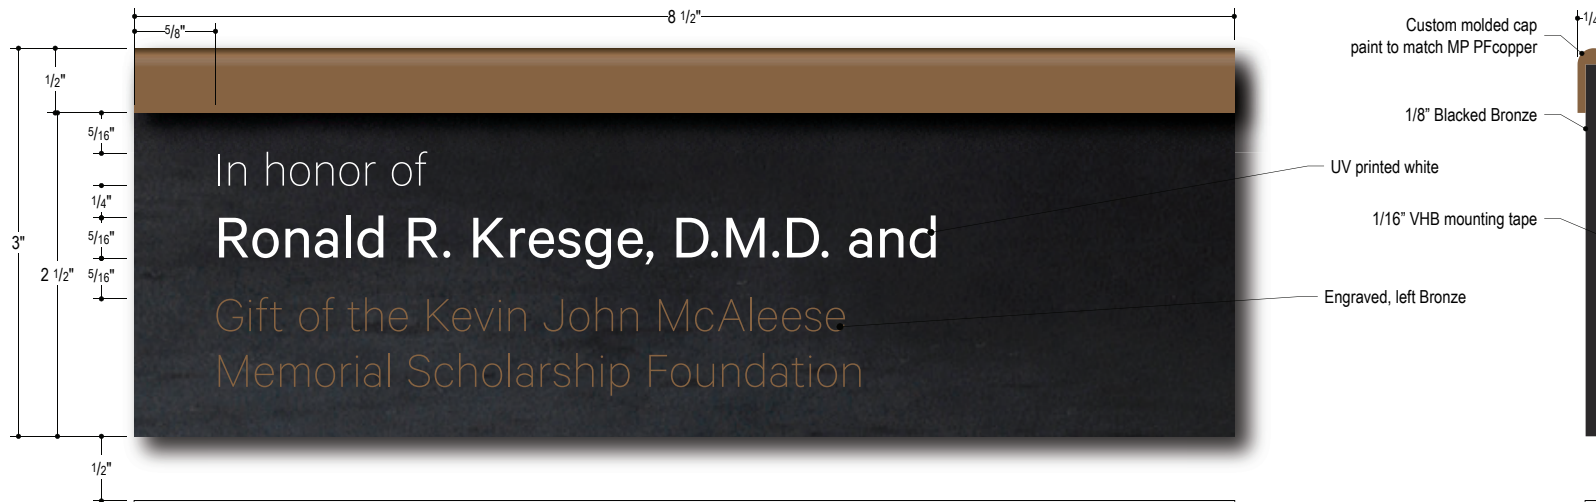

Existing room Sign

Approved by:

Date:





**JOB SPECIFICATIONS**

User Name: Penn First  
 Job Name: Penn First Pavilion Donor AS BUILT  
 Job #: 51856  
 Customer Name: Cloud Gehshan  
 Sales Rep: EJ | Drawn By: MLH  
 Revision #: 3  
 Sign Type: Open Space Dedication-Tier 1  
 Date: 08.02.2022  
 File Location: Penn First\ AS BUILT

**SIGN PANEL**

Face: 1/4" Bronze  
 Edges: Straight  
 Corners: Square  
 COLOR | 1st Surf: Blacked Bronze  
 | 2nd Surf: NA  
 Insert/Slat: NA  
 Vinyl: NA  
 2nd Layer: NA  
 COLOR | 1st Surf: NA  
 | 2nd Surf: NA  
 Sides: Single

**CONTENT**



Process: Engraved (WHITE TEXT UV PRINTED)  
 TEXT/COPY | Height: See Drawing  
 | Style: Calibre Thin and Regular  
 | Color: White, MP PFCopper  
 Braille: NA

**MOUNTING**

Hardware: 8" Locking Z-Clips w. Lords 419  
 Holes/Location: NA  
 Tape: NA  
 Mounting Surface: TBD  
 Glass Backer Mat/Color: NA

**FRAME**

Type: (Cap) PVC Moulded  
 Size: See Drawing  
 Color: MP PFCopper

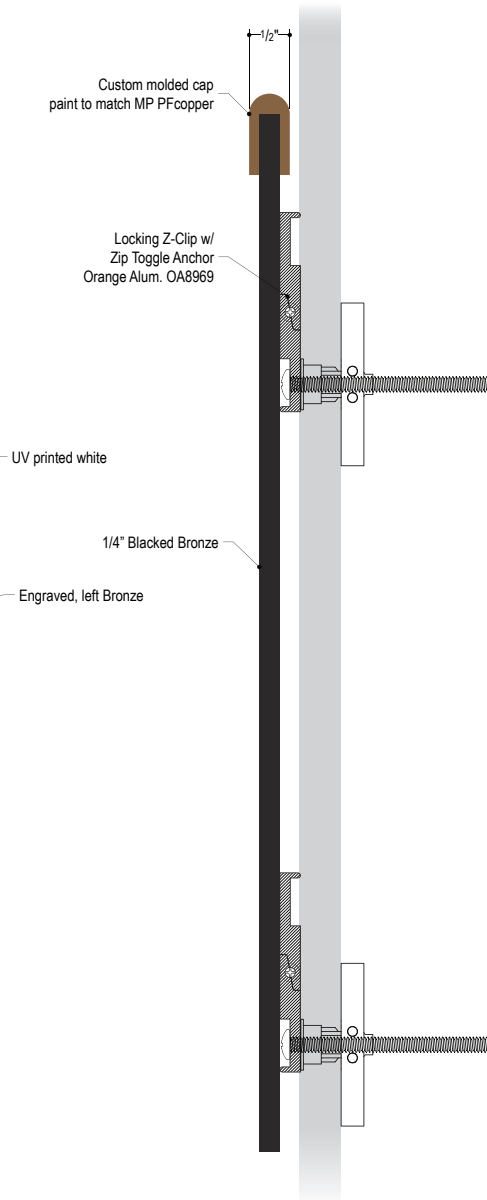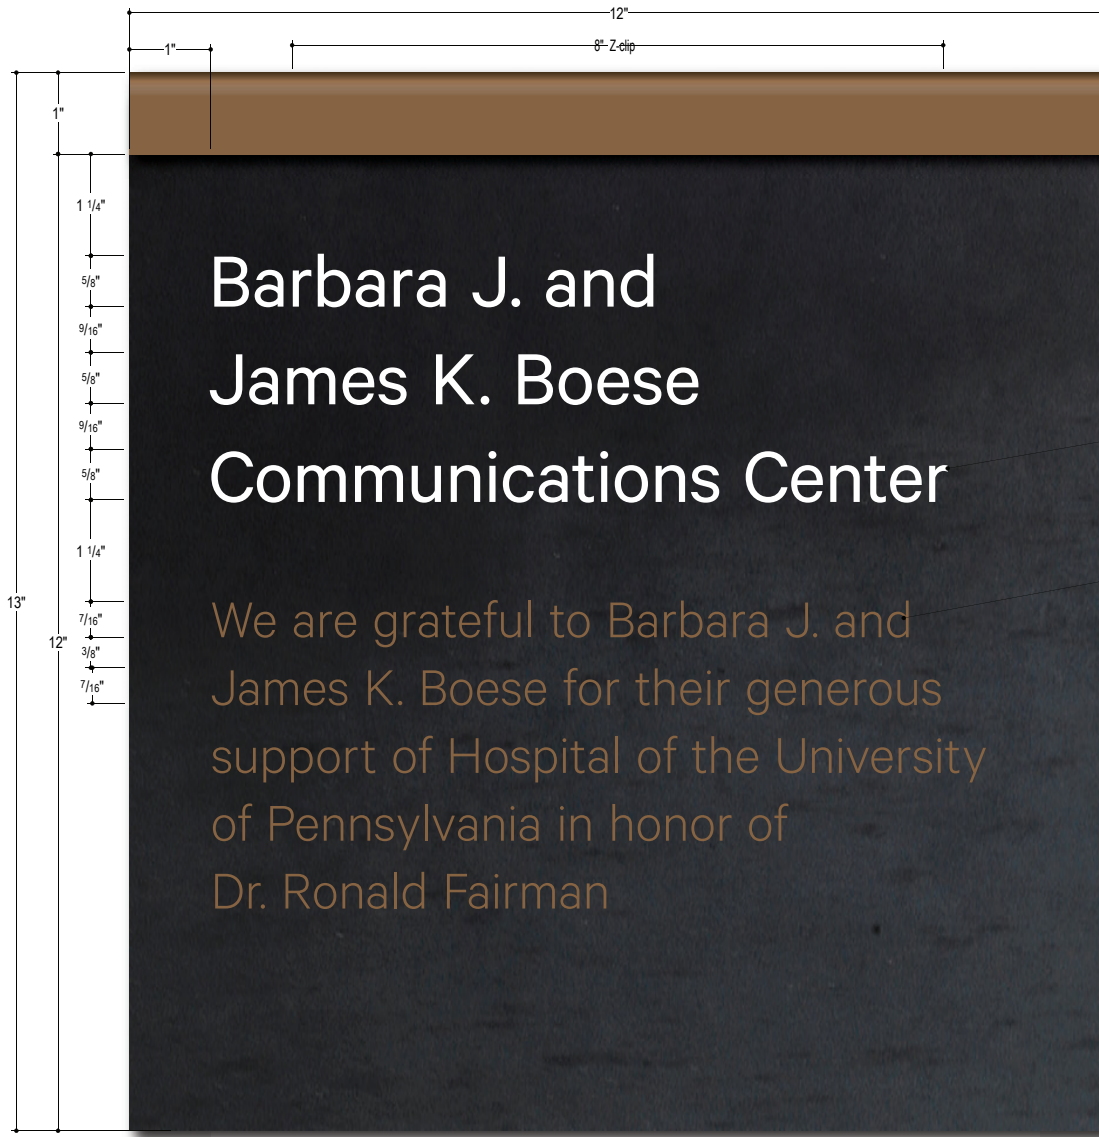

Approved by:

Date:



**JOB SPECIFICATIONS**

User Name:	Penn First	
Job Name:	Penn First Pavilion Donor AS BUILT	
Job #:	51856	
Customer Name:	Cloud Gehshan	
Sales Rep:	EJ	Drawn By: MLH
Revision #:	3	
Sign Type:	Open Space Dedication-Tier 2	
Date:	08.02.2022	
File Location:	Penn First\AS BUILT	

**SIGN PANEL**

Face:	1/4" Bronze
Edges:	Straight
Corners:	Square
COLOR	1st Surf: Blacked Bronze
	2nd Surf: NA
Insert/Slat:	NA
Vinyl:	NA
2nd Layer:	NA
COLOR	1st Surf: NA
	2nd Surf: NA
Sides:	Single

**CONTENT**



Process:	Engraved (WHITE TEXT UV PRINTED)	
TEXT/COPY	Height:	See Drawing
	Style:	Calibre Thin and Regular
	Color:	White, MP PFcopper
Braille:	NA	

**MOUNTING**

Hardware:	8" Locking Z-Clips w. Lords 419
Holes/Location:	NA
Tape:	NA
Mounting Surface:	TBD
Glass Backer Mat/Color:	NA


**FRAME**

Type:	(Cap) PVC Moulded
Size:	See Drawing
Color:	MP PFcopper

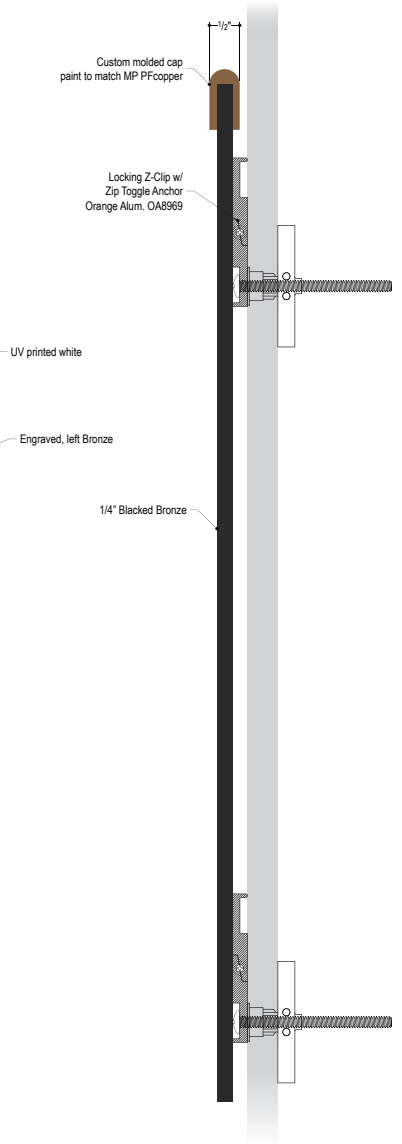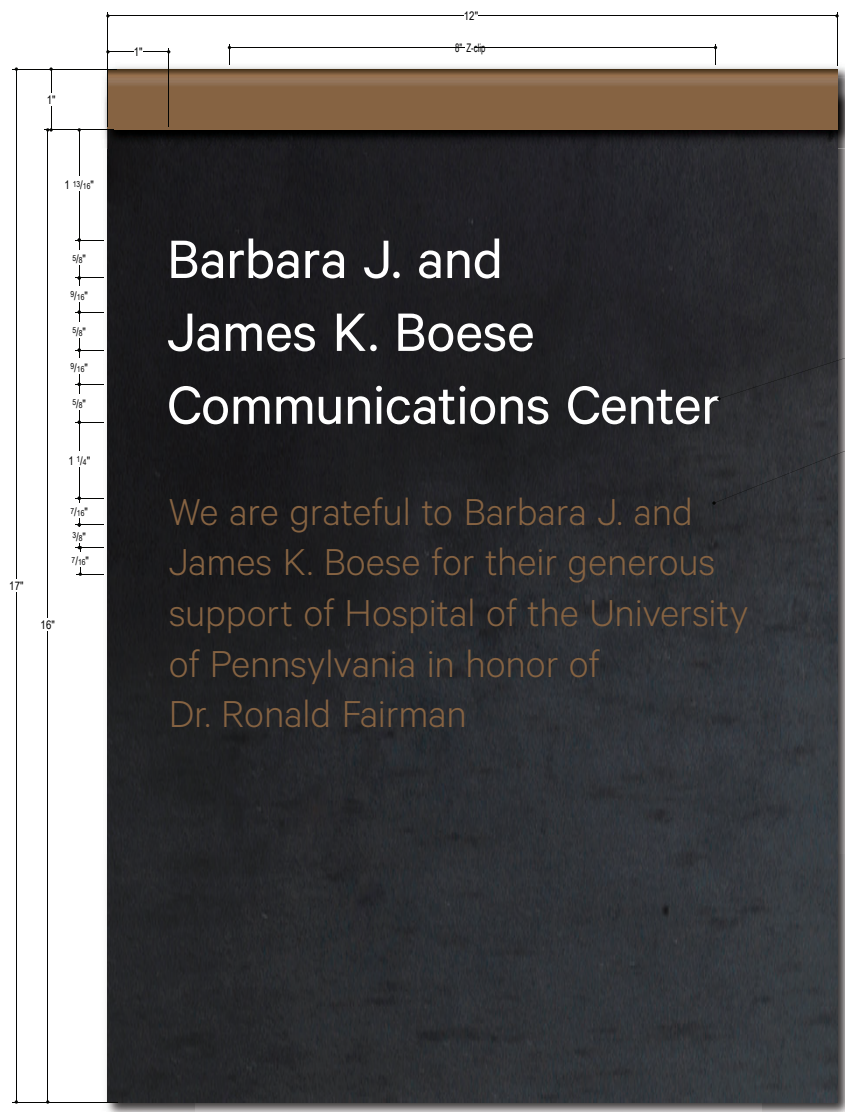

Approved by:

Date:

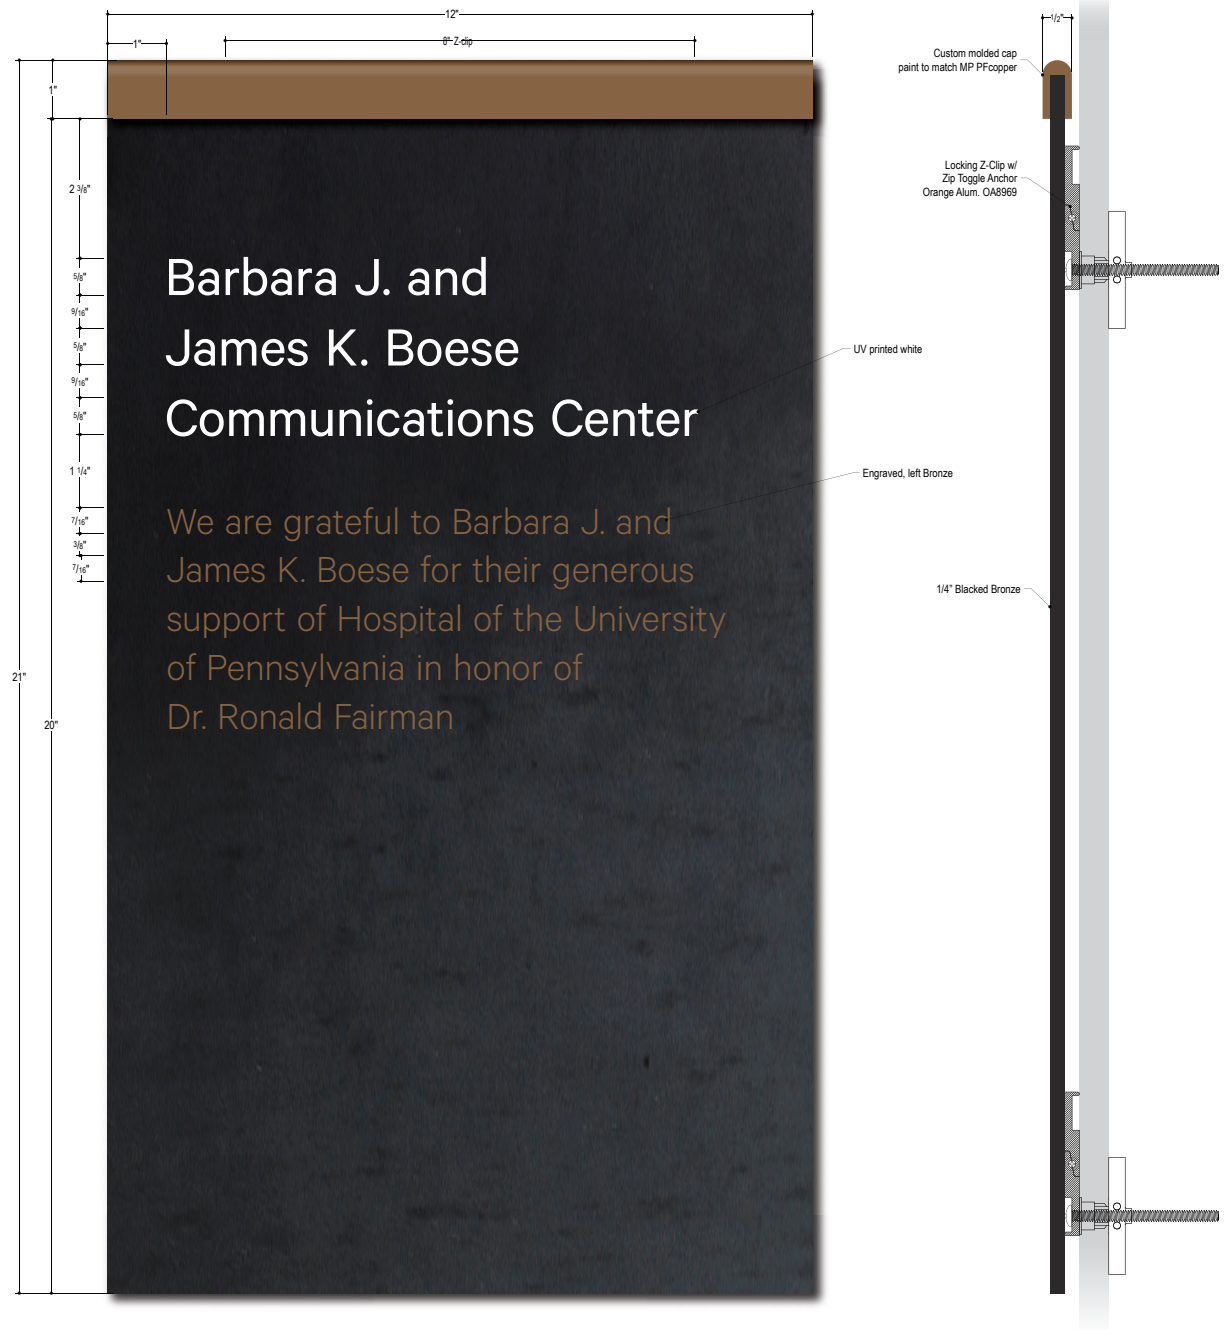

**JOB SPECIFICATIONS**

User Name: Penn First	
Job Name: Penn First Pavilion Donor AS BUILT	
Job #: 51856	
Customer Name: Cloud Gehshan	
Sales Rep: EJ	Drawn By: MLH
Revision #: 3	
Sign Type: Open Space Dedication-Tier 3	
Date: 08.02.2022	
File Location: Penn First\AS BUILT	

**SIGN PANEL**

Face: 1/4" Bronze	
Edges: Straight	
Corners: Square	
COLOR	1st Surf: Blacked Bronze
	2nd Surf: NA
Insert/Slat: NA	
Vinyl: NA	
2nd Layer: NA	
COLOR	1st Surf: NA
	2nd Surf: NA
Sides: Single	

**CONTENT**

Process: Engraved (WHITE TEXT UV PRINTED)	
TEXT/COPY	Height: See Drawing
	Style: Calibre Thin and Regular
	Color: White, MP PFcopper
Braille: NA	

**MOUNTING**

Hardware: 8" Locking Z-Clips w. Lords 419	
Holes/Location: NA	
Tape: NA	
Mounting Surface: TBD	
Glass Backer Mat/Color: NA	

**FRAME**

Type: (Cap) PVC Moulded	
Size: See Drawing	
Color: MP PFcopper	

Approved by: \_\_\_\_\_ Date: \_\_\_\_\_